IF THIS DRAWING IS NOT 24"x36" IT IS A REDUCED PRINT SCALE ACCORDINGLY

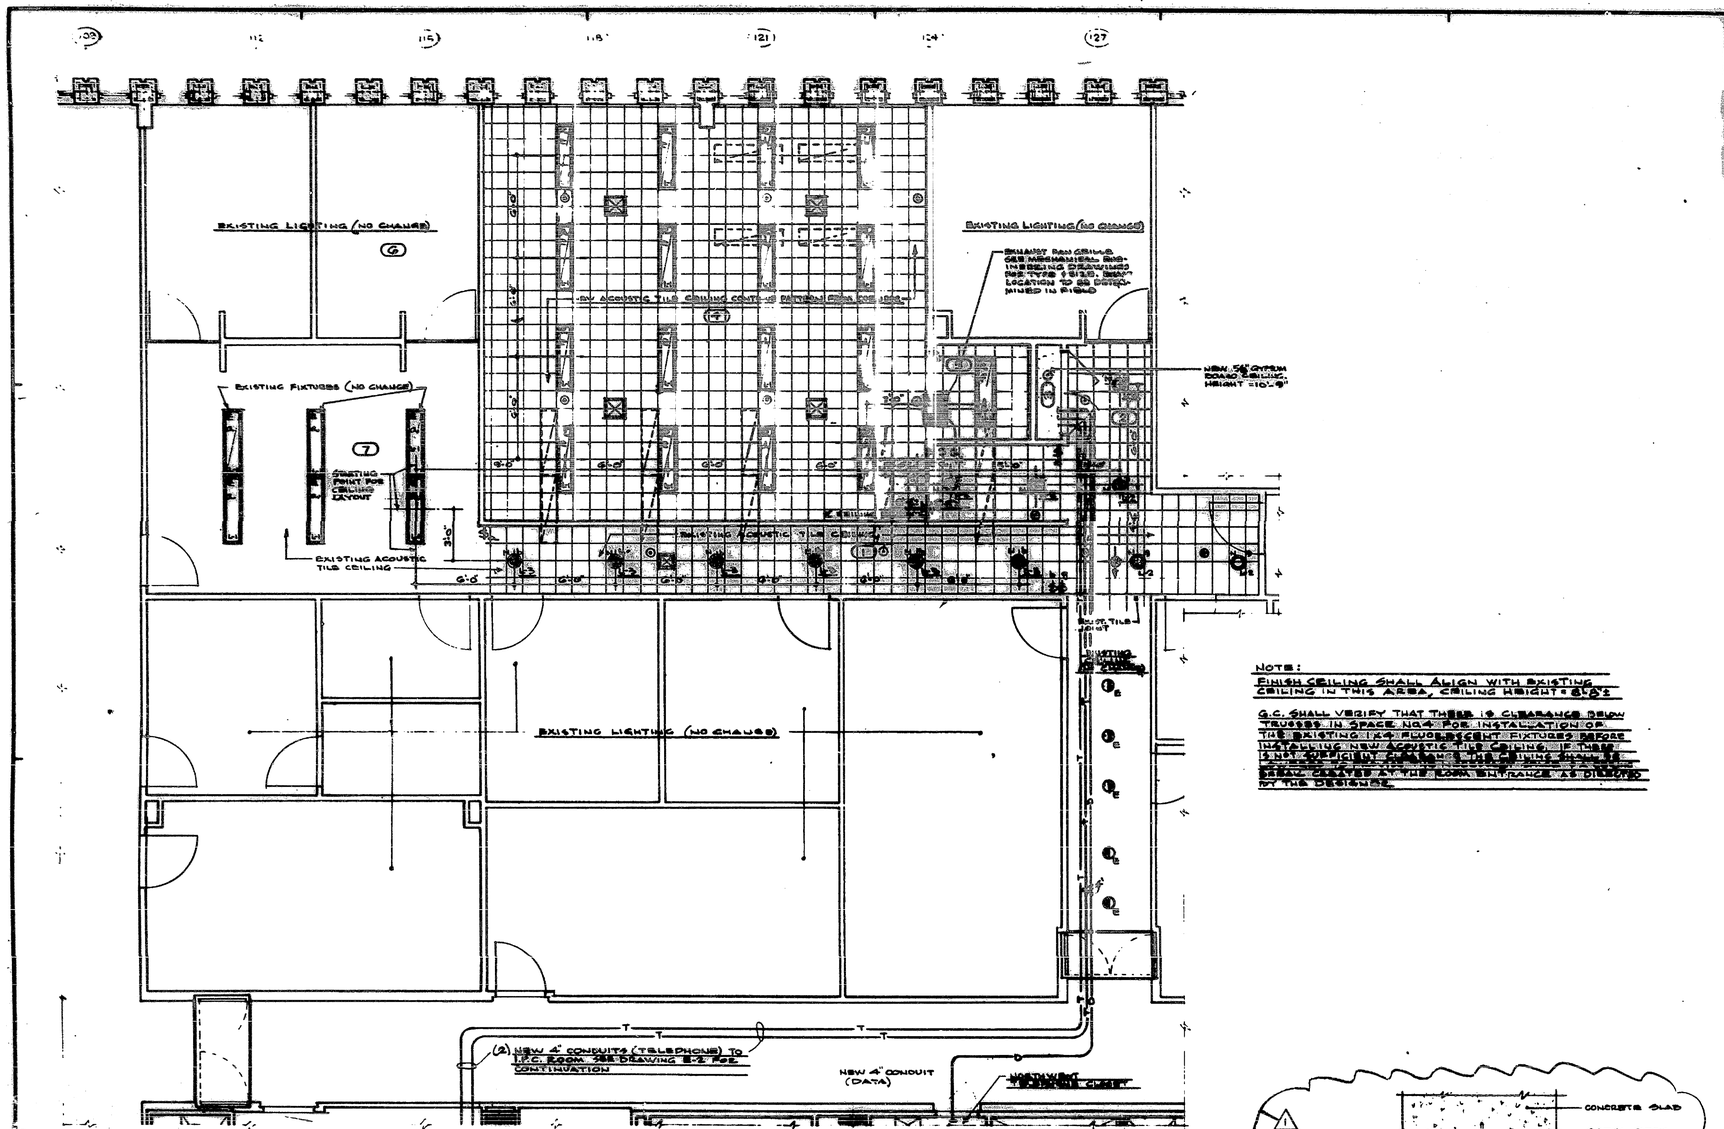

PART PLAN 105TH FLOOR

NOTE:
FINISH CEILING SHALL ALIGN WITH EXISTING CEILING IN THIS AREA, CEILING HEIGHT = 8'-2"

G.C. SHALL VERIFY THAT THERE IS CLEARANCE BELOW TRUSSES IN SPACE NO. 4 FOR INSTALLATION OF THE EXISTING 1X4' FLUORESCENT FIXTURES BEFORE INSTALLING NEW ACOUSTIC TILE CEILING. IF THERE IS NOT ATT LEAST [illegible] CEILING [illegible] AREA CREATED AT THE ROOM ENTRANCE AS DIRECTED BY THE DESIGNER.

SCHEDULE OF LIGHTING FIXTURES

NO	SYMBOL	MANUFACTURER & CATALOG NO.	DIMENSIONS	LAMP TYPE	TOTAL NO. REQ'D	TOTAL NO REMOVED	NO. RELOCATED	NEW REQ'D	REMARKS
L-1	L-1	EDISON PRICE "VISIONAIR" VE-240-C2-277 RECESSED FLUORESCENT DOUBLE LAMP PARABOLIC AIR HANDLING	L=4'-0" W=1'-0" H=5⅝"	(2) F-40 T-12 DELUXE WARM WHITE	17	17	17	0	
L-2	L-2	LIGHTOLIER 3BJ94 OPEN REFLECTOR RECESSED DOWNLIGHT WITH SPECULAR CLEAR ALZAK REFLECTOR	6" APERTURE 7⅛" DIA. DIA. 8⅞" HIGH	100 W A-19	6	0	0	6	SIZE CIRCUIT FOR POSSIBLE USE OF 150W LAMPS
L-3	L-3	LIGHTOLIER 3BN71 OPEN REFLECTOR RECESSED DOUBLE WALL WASHER WITH SPECULAR CLEAR ALZAK REFLECTOR.	5⅝" APERTURE 7⅞" DIA. DIA. 8⅛" HIGH	100 W A-19	6	0	0	6	SIZE CIRCUIT FOR POSSIBLE USE OF 150W LAMPS

NOTE: THE USE OF PLASTIC LIGHTING FIXTURE DIFFUSERS IS PROHIBITED IN THE WORLD TRADE CENTER.

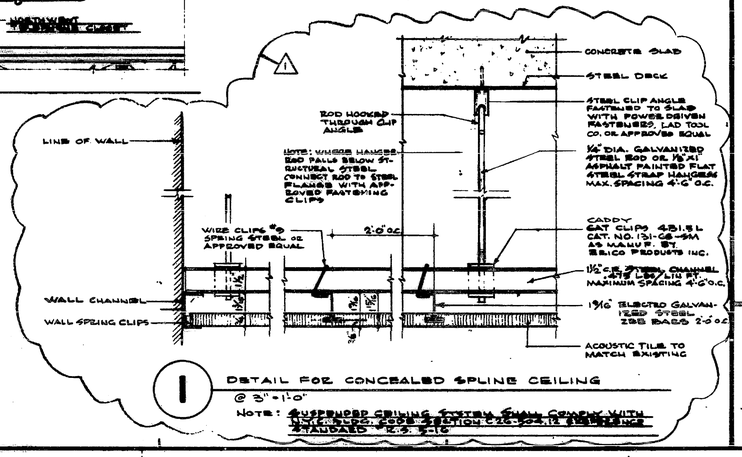

1 DETAIL FOR CONCEALED SPLINE CEILING
@ 3"=1'-0"

SYMBOL LEGEND

	LIGHTING FIXTURE SEE SCHEDULE THIS SHEET D = EXISTING N = NEW R = RELOCATED
	EXISTING LIGHTING FIXTURE TO BE REMOVED & RELOCATED
$	SWITCH, LOWER CASE LETTER DENOTES FIXTURE CONTROLLED
$K	KEY OPERATED SWITCH
—T—	NEW CONDUIT FOR TELEPHONE WIRING
—D—	NEW CONDUIT FOR LOW VOLTAGE DATA CABLES
	AIR CONDITIONING SUPPLY DIFFUSER SEE MECHANICAL DWGS FOR SIZES, TYPE & DUCTWORK
	DIRECTIONAL EXIT LIGHT (EXISTING RELOCATE AS SHOWN)
	FLUSH SPRINKLER HEAD

NOTE:
THIS DRAWING SHALL BE USED FOR CEILING LAYOUT, SWITCHING ARRANGEMENT EQUIPMENT LOCATION ONLY. SEE ELECTRICAL ENGINEERING DRAWINGS FOR CIRCUITING, PANEL BOARD CONNECTIONS & ELECTRICAL SPECIFICATIONS

AREA SHOWN ON THIS DRAWING

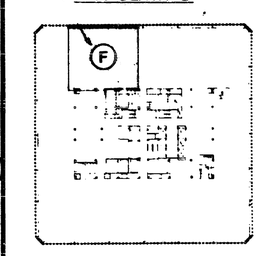

KEY PLAN
1 : 64 : 1'-0

PHASE
F
TAA NO. 3104
AS BUILT DWG.
5-1-85

CHARLES D FLAYHAN ASSOCIATES INC
880 CANAL STREET STAMFORD CT 06902
203 348 4100

DATE	ISSUED TO	PR	TR
12-7-84	PORT AUTHORITY FOR APPROVAL	10	1
	CIVALE CORP. FOR BIDS	9	1
	C.P.&C. FOR RECORD	5	–
1-18-85	PORT AUTHORITY FOR APPROVAL	10	1
	CIVALE CORP. FOR INFORMATION	3	1
	C.P.&C. FOR RECORD	3	–
5-9-85	PORT AUTHORITY "AS BUILT"	0	2

AS-BUILT DRAWING
DATE 5/22/86
INSPECTOR [illegible]

NO	DATE	REVISION	BY
2	4-29-85	GENERAL REVISION TO CONFORM TO AS BUILT CONDITIONS	JFP
1	1-11-85	ADDED CEILING DETAIL PER PORT AUTHORITY REQUEST	JFP

CANTOR, FITZGERALD SECURITIES CORP.
105th FLOOR
ONE WORLD TRADE CENTER, NEW YORK N.Y.

NEW CORPORATE BOND TRADING ROOM
REFLECTED CEILING PLAN

NORTH

PROJECT NO	1357 A
SCALE	1/4 : 1'-0
DRAWN BY	J.F.P
CHECKED BY	
DATE	12-6-84

DRAWING NO
105F
4

DRAWING NUMBER